


LEGEND

- ELEC — ELECTRICAL LINE
- WATER — WATER LINE
- FIBER OPTIC LINE — FIBER OPTIC LINE
- ↔ MAIN ESCAPE ROUTE
- ↔ SECONDARY ESCAPE ROUTE
- + FIRST AID
- ELECTRIC SUBSTATION
- ELECTRICAL BOX
- TELEPHONE
- ⬇ 2013 SURFACE CONTROL MONUMENT
- ⬇ FRESH AIR FLOW
- ⬇ EXHAUST AIR FLOW
- AIR STOPPINGS
- AIR STOPPINGS WITH DOORS
- BERM
- ABANDONED AREA
- BAT HIBERNACULUM
- BAT HIBERNACULUM BUFFER

AS-BUILT READINGS

- 2013 DATA FROM POINTS NO. 1, 2, 3
- 2013 DATA FROM POINTS NO. 4
- 2013 DATA FROM POINTS NO. 5
- 2013 DATA FROM POINTS NO. 6
- 2013 DATA FROM POINTS NO. 7

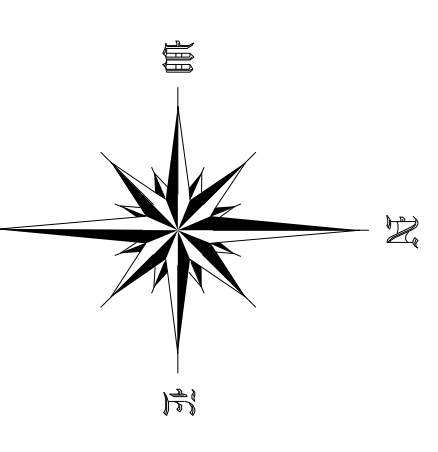

B-2
SHEET NO.

| PROJECT NO. | CAD FILE | SURVEYED BY | DRAWN BY | APPROVED BY | NO. | DATE | REVISIONS | BY |
|-------------|-------------|-------------|------------|-------------|-----|------|-----------|----|
| 17-0504 | 17-0504.dwg | TMH | TMH | | | | | |
| DATE | CRD FILE | SURVEY DATE | CHECKED BY | SCALE | | | | |
| 6/14/2017 | 17-0504.crd | 6/1/2017 | TMH | 1"=400' | | | | |

WISCONSIN INDUSTRIAL SAND COMPANY, LLC
A DIVISION OF FAIRMOUNTSANTROL
BAY CITY, WISCONSIN
BAT HIBERNACULUM



Healy Land Surveying
P.O. Box 221
Niagara, WI 54151
Phone: 715-548-0566
info@healysurveying.com